

NEAR 1622 CONNECTICUT STATE HIGHWAY (ROUTE 12)
T.O.L ADDRESS PARCEL - #109 CHRISTY HILL ROAD


1" CORPORATION (MUELLER MODEL NO. H-15008)

1" CURB STOP (MUELLER MODEL NO. B-25209)

OPEN LEFT (COUNTER CLOCKWISE)

1" COPPER TUBE (TYPE K)

INSTALLED: NOVEMBER 4, 1997

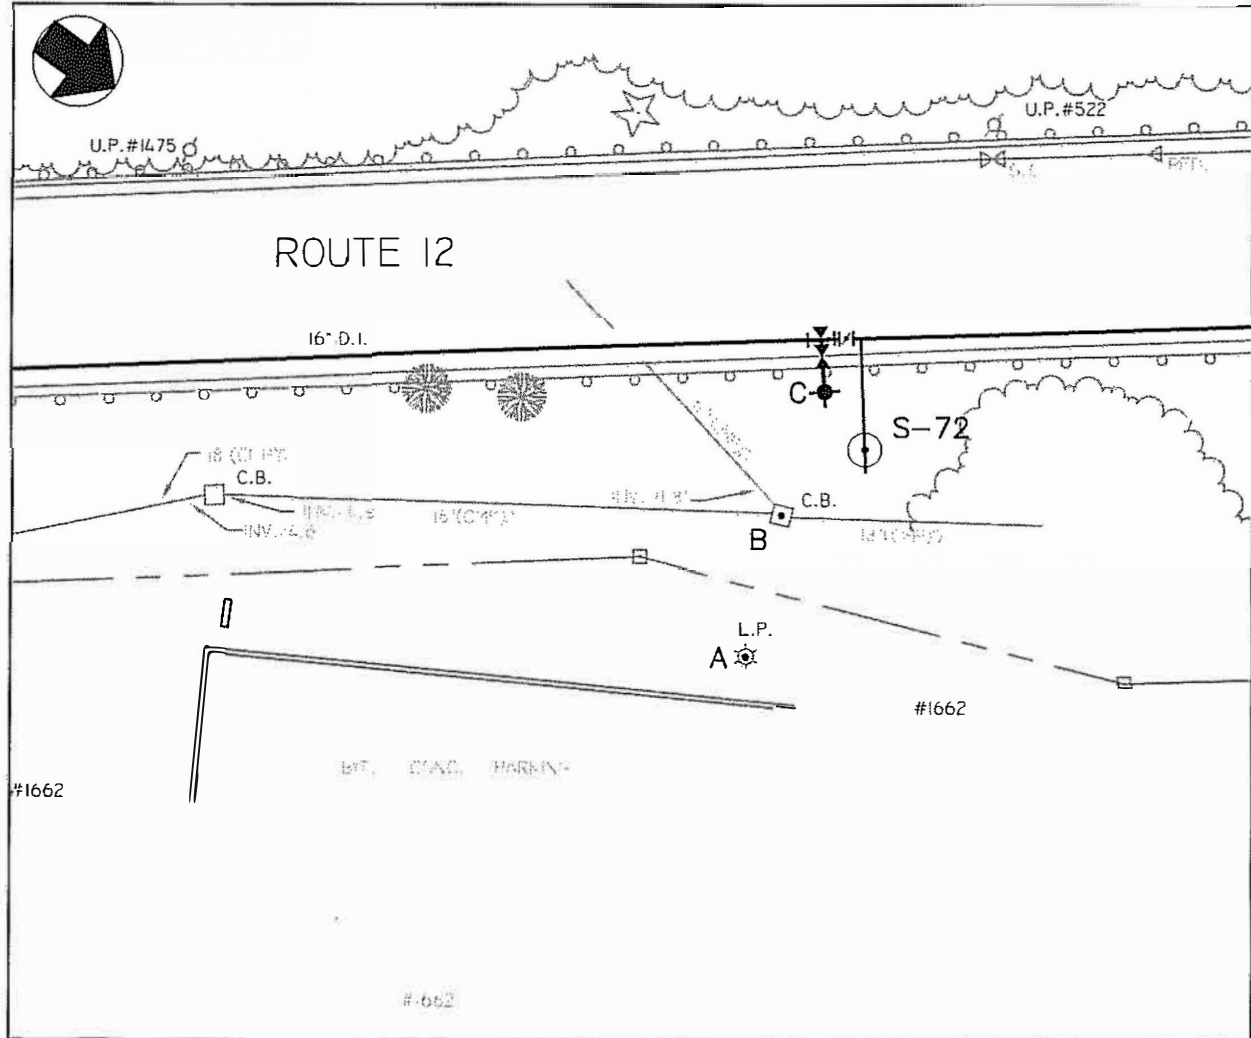

SERVICE TIES

	A	B	C
CURB STOP	LIGHT POLE EAST OF ROUTE 12 WEST OF PARK. LOT #1622	C.B. EAST OF ROUTE 12 WEST OF LIGHT POLE	HYDRANT (40) EAST OF ROUTE 12
S-72	52.0'	22.0'	16.0'
MAIN TO SERV. = 22.5'		CURB TO COUPLING = 5.0'	

SERVICE RECORD
 GALES FERRY WATER SYSTEM
 RECORD DRAWINGS
 PHASE 1

WATER POLLUTION CONTROL AUTHORITY
 LEDYARD, CONNECTICUT

DATE: 1/26/99

SCALE: 1" = 40'-0"

REVISED: 1/28/99

SHEET: PH1-SH6-52

AMORY ENGINEERS, P.C.