

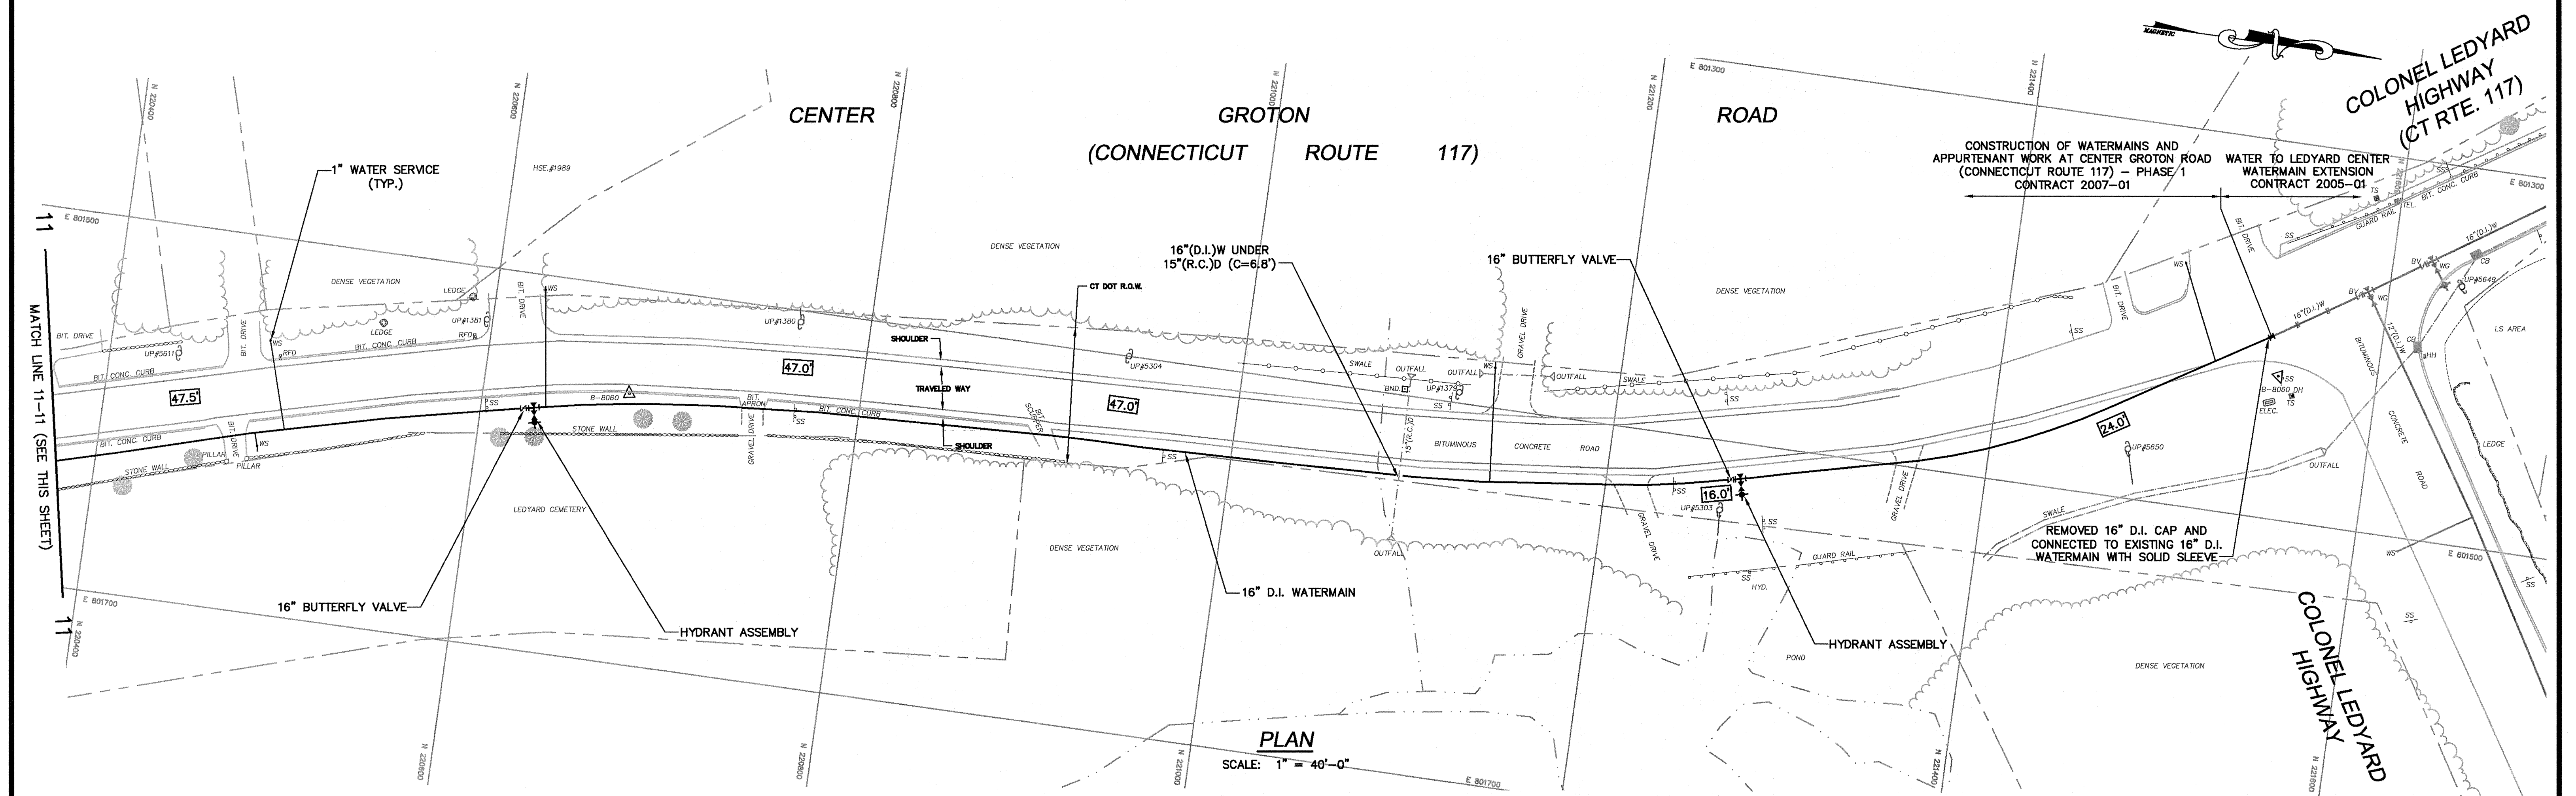


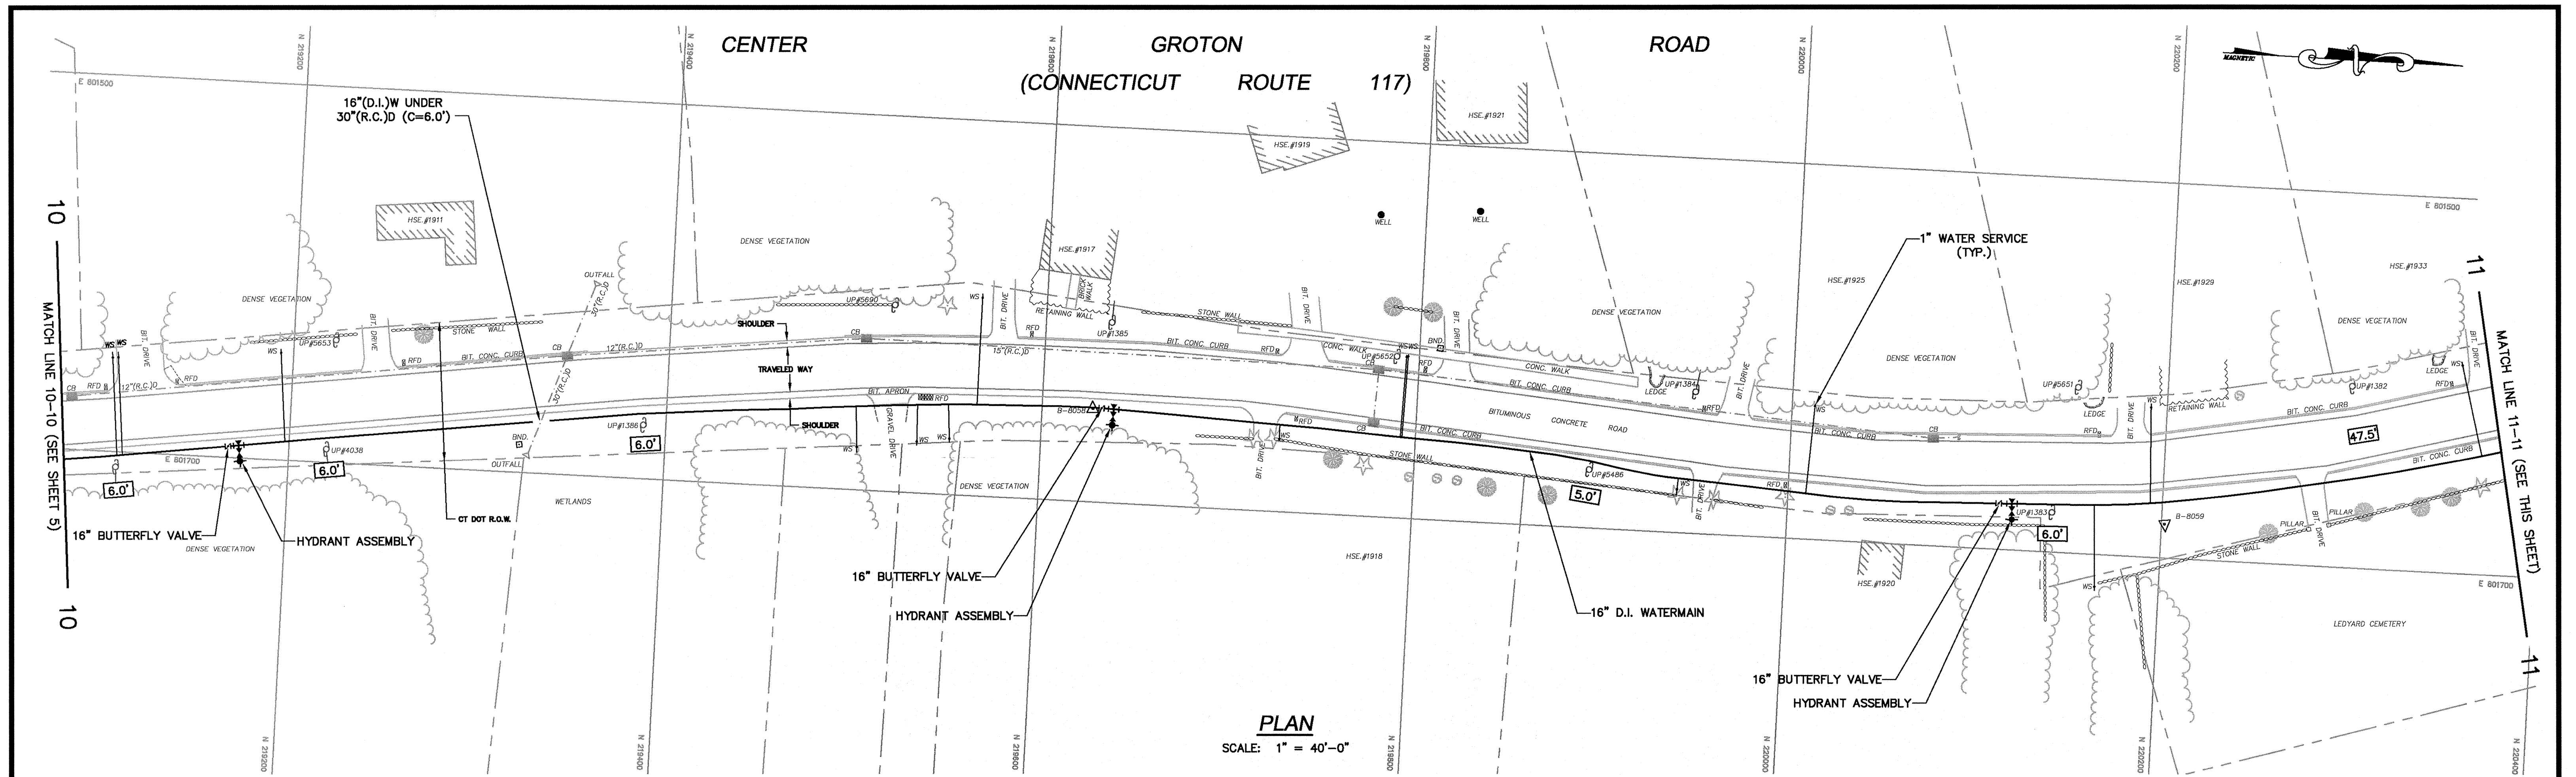

RECORD DRAWING

28.0 UTILITY POLE OFFSET TO C OF WATERMAIN

REVISIONS		
NO.	ITEM	DATE
1.	LEDYARD DPW/CT DOT REVIEW	3/9/06
2.	ISSUED FOR PERMITTING	5/17/06
3.	ISSUED FOR BIDDING	6/27/06
4.	RECORD DRAWINGS	3/11/09

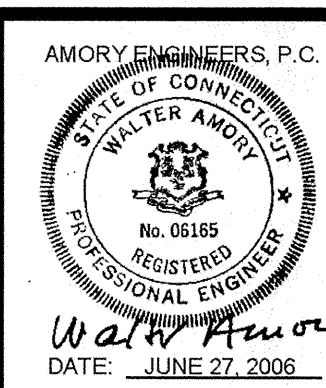

AMORY ENGINEERS, P.C.	
DUXBURY, MASSACHUSETTS	
DRAWN BY: RJT	FILE NAME: AS SHOWN
DESIGNED BY: RJT	JOB NO.: 2760
CHECKED BY: RSJ	DATE: 12/19/05
	SCALE: AS SHOWN
	DWG. NO.: 1373
	CONTRACT: 2007-01

WATER POLLUTION CONTROL AUTHORITY LEDYARD, CONNECTICUT	
CONSTRUCTION OF WATERMAINS AND APPURTENANT WORK AT CENTER GROTON ROAD (CONNECTICUT ROUTE 117) - PHASE 1	
PLANS - 6 CENTER GROTON ROAD (CT RTE. 117)	
CIVIL	SHEET
	6 OF 10

L009B